

~ REVISIONS ~

Dimensions Changed Per Deeds 12-15-32 Ch Sh # 674+678
 LOT 24 DIV. PER DEED CH. SH. 83-153
 LOT 32/33 PER. APPL. C. SH. 84-552
 LOTS 32/33 & 34 CONSID. PER. O.O. C. SH. 93-120




6286
~~6286~~

MT. PLEASANT

AVE.

S. CONKLING ST.

S. EATON ST.

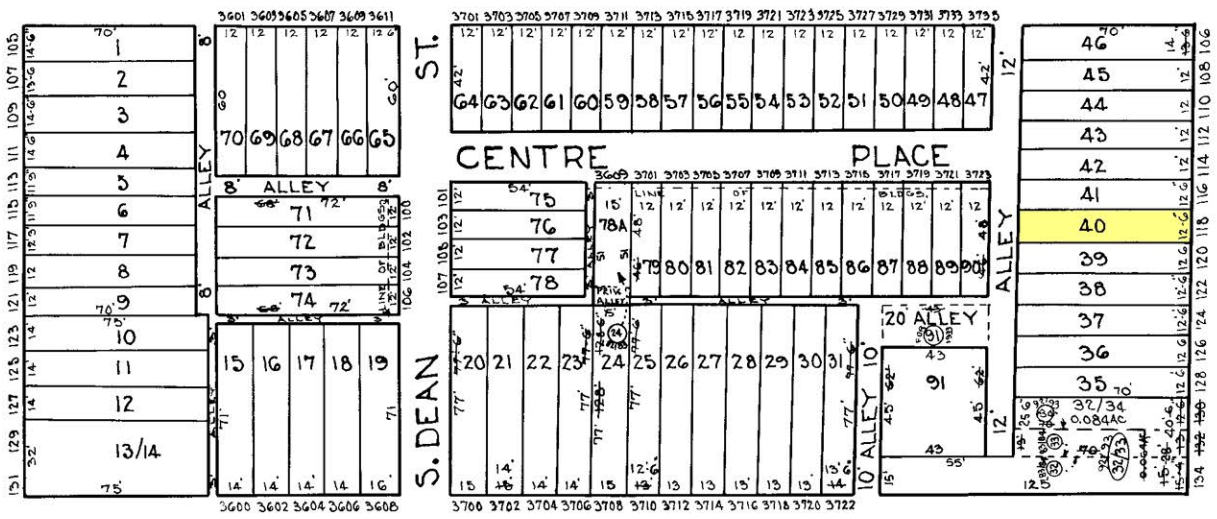

E. PRATT

ST.

6302
~~6302~~

NOTICE
 THIS IS A REAL PROPERTY PLAT AS PROVIDED
 FOR UNDER ARTICLE 76(I) OF THE CITY CHARTER
 IT IS COMPILED FROM TITLE AND OTHER
 SOURCES AND IS NOT AN AUTHENTIC SURVEY

NOTE ÷ BLOCK 26-15-2 FOR 1941

6287
 CITY OF BALTIMORE
 DEPARTMENT OF PUBLIC WORKS
 BUREAU OF CONSTRUCTION MGMT.
 PROPERTY LOCATION DIVISION
 WARD 26 SECTION 15
 BLOCK 6287
 SCALE 1"=50'-0" DATE Dec. 1932

TRACED BY M.C. STUMPF...
 LETTERED BY M.C.S.
 CHECKED BY