


REVISIONS?

Lot 1 Per App. 3726/31 C. Sh. 4404  
Lot 2 Per App. C. Sh. G403-09  
LOT ACRES CORR PER PLS. C. SH. 446

### "PARK RAVEN APARTMENTS"

NOTE

Entire Apartment area Assessed as Lot 1  
and Known as 5801-5811 Hillen Rd.  
~~79.969 Acres Entire Tract lot 1 1948~~  
~~14.774 Acres To Apts. lot 1 1949~~  
~~15.195 Acres Res. 126-48~~  
~~5.155 Acres Bed of Ave.~~  
~~10.640 Acres Res. 8-18-48 to 12~~

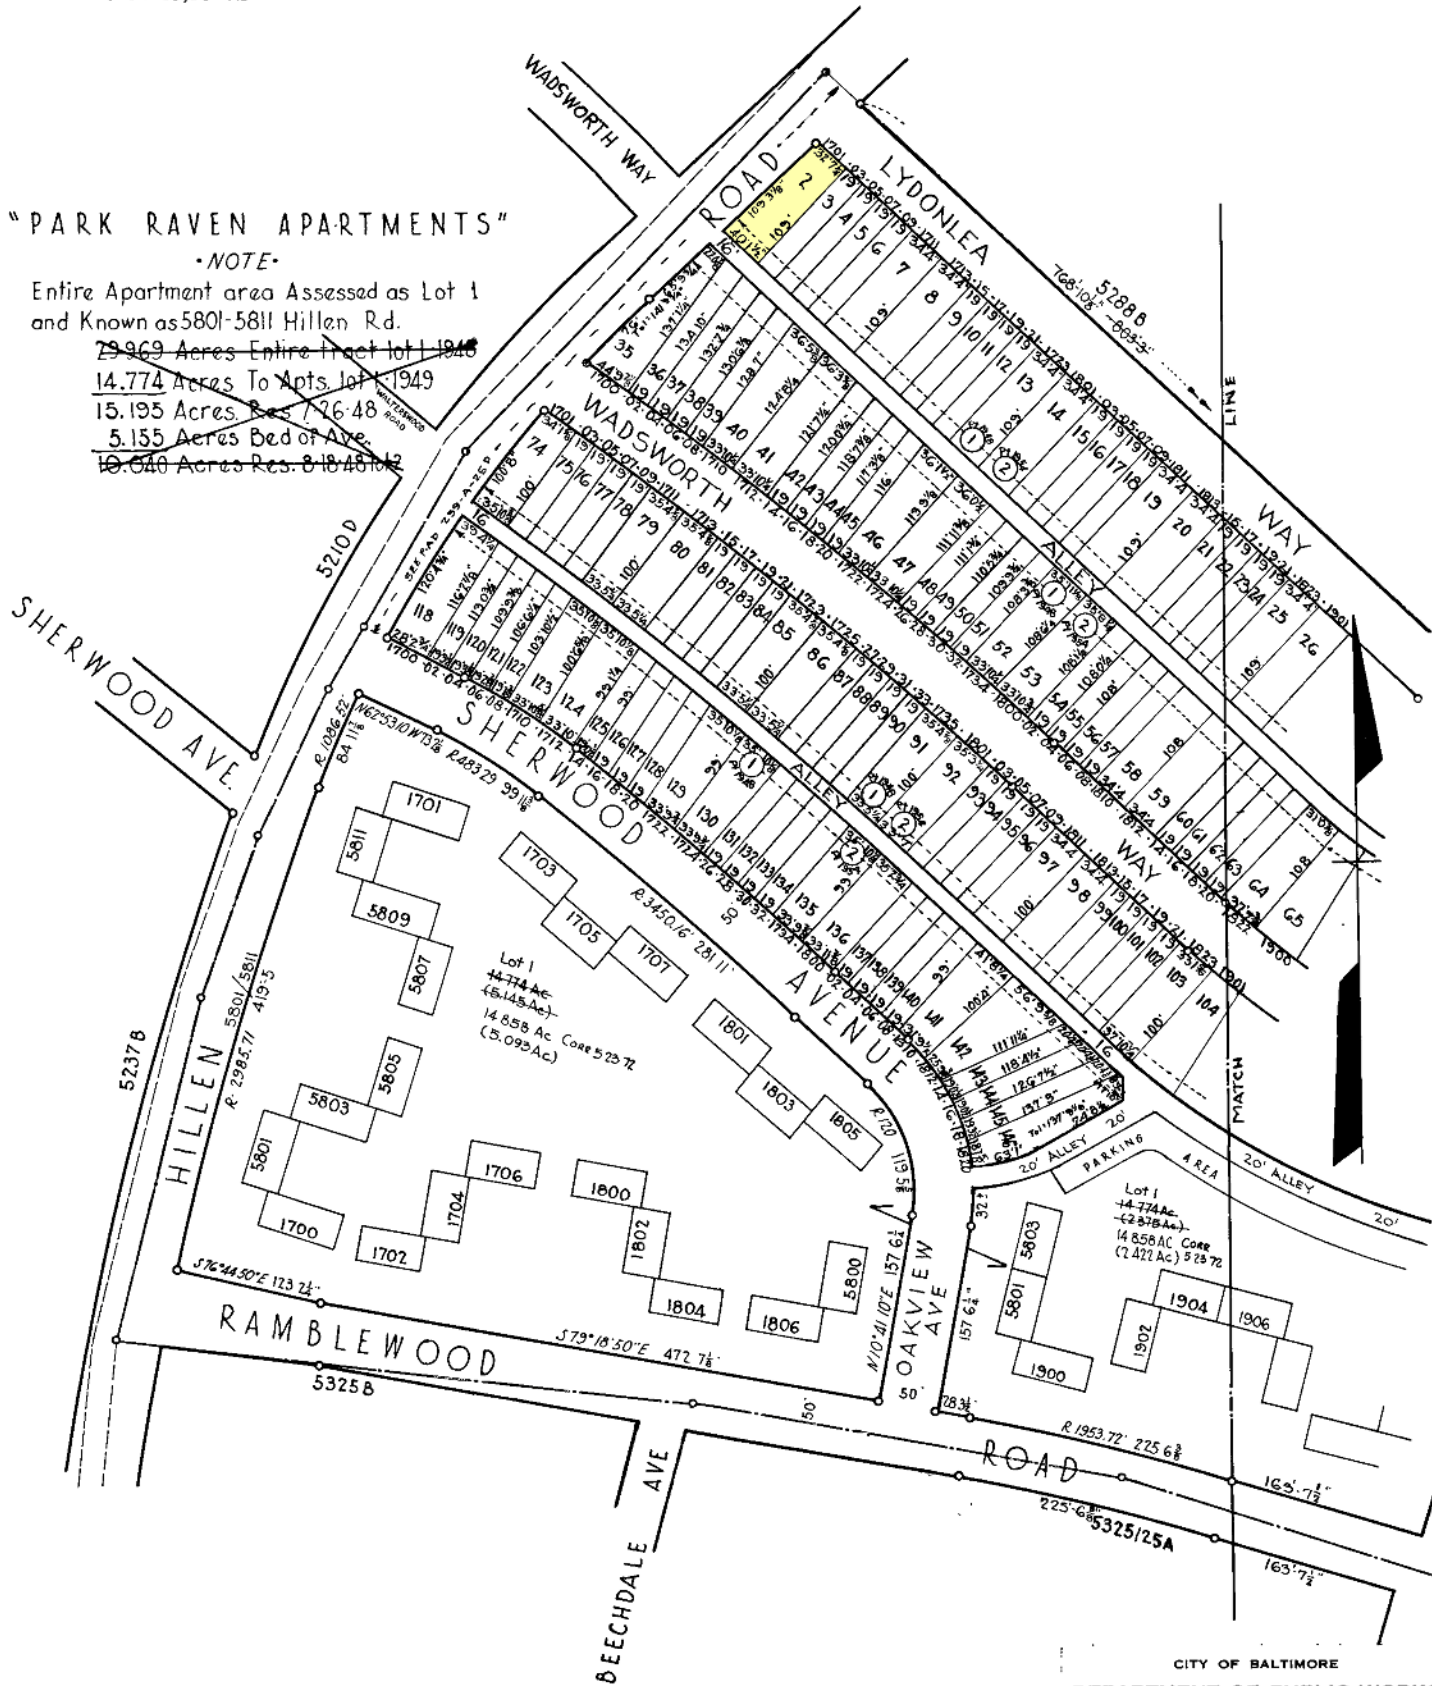

**NOTICE**  
THIS IS A REAL PROPERTY PLAT AS PROVIDED FOR UNDER ARTICLE 76(f) OF THE CITY CHARTER. IT IS COMPILED FROM TITLE AND OTHER SOURCES AND IS NOT AN AUTHENTIC SURVEY.

SHEETS IN SET, 2  
SHEET Number 1

CITY OF BALTIMORE  
DEPARTMENT OF PUBLIC WORKS  
BUREAU OF PLANS & SURVEYS  
PROPERTY LOCATION DIVISION

WARD 27 SECTION 29/30  
BLOCK 5288A

SCALE 1 inch = 100 feet. DATE July 1948

TRACED BY J.M.PANUSKA  
LETTERED BY J.M.PANUSKA  
CHECKED BY