


FW4611

FILED
MAR 16 9 07 AM '79
FRANK W. BALES, CLK.
CT. CT. WOR. CO.

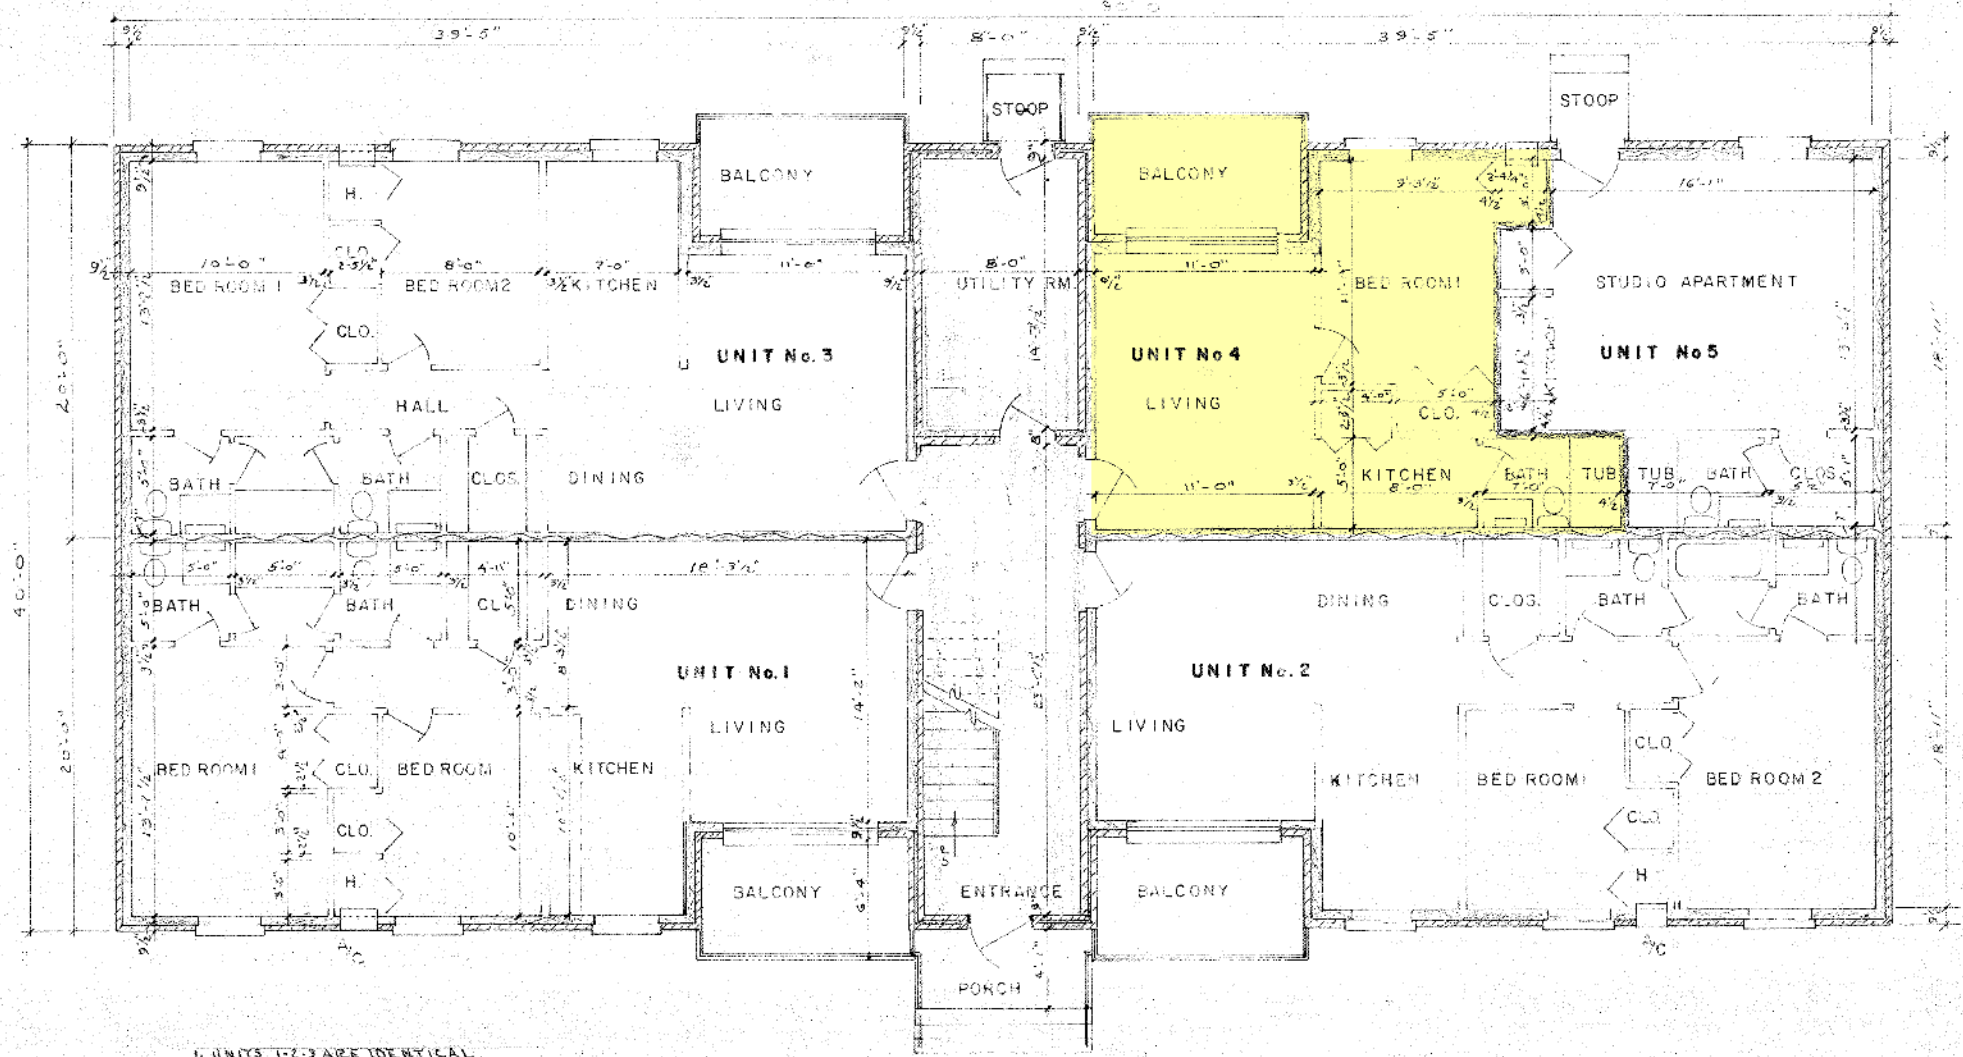

- 1. UNITS 1-2-3 ARE IDENTICAL.
- 2. ALL BALCONY DIMENSIONS ARE SAME

FIRST FLOOR PLAN

SCALE: 3/8" = 1'-0"


NOTE: ALL DIMENSIONS & INDICATIONS ARE AS BUILT

SAND & FOAM CONDOMINIUM

DRAWINGS PREPARED BY W.S.A.

Sheet 2 of 6

MSA CSU 2457-1547-2

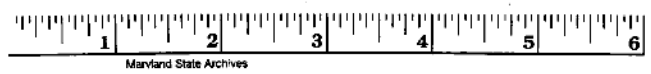

WORCESTER COUNTY CIRCUIT COURT (Plat Book) Plat Book FWH 61, pp. 10-15, MSA_C2157_1547. Date available 1979/03/16. Printed 09/23/2024.