


BALTIMORE COUNTY CIRCUIT COURT (Condominium Plats, BA) Condominium Book ENR, Jr. 4, pp. 96-116, MSA_51265-744, Date available 1975/06/11. Printed 11/15/2024.




LEGEND

- Limited Common Element
- Unit Boundary
- T2-1 - Unit Number

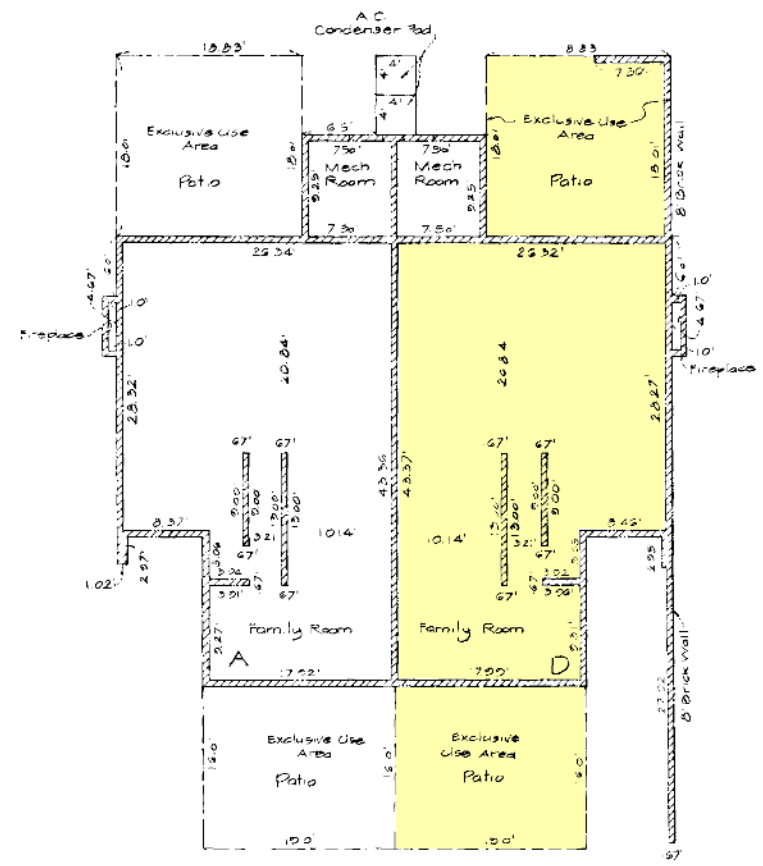

FIRST FLOOR

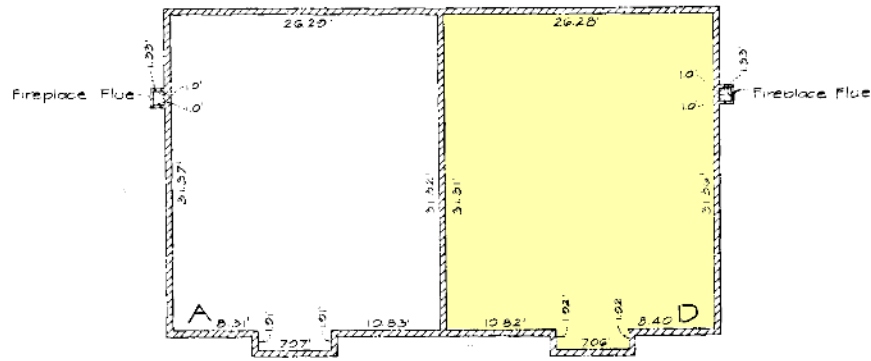


SECOND FLOOR

BUILDING T2-1

NOTE:

Elevations shown hereon are referred to Zero Datum Mean Low Tide City of Baltimore Topographic Survey Commission, Sewage Control Harbor Board.

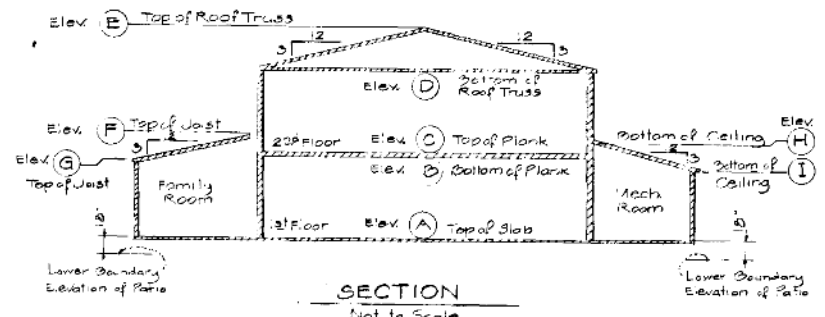

NOTE:
All Limited Common Element walls are 6.57' thick except where noted otherwise.

TABLE OF ELEVATIONS

UNIT NO.	ELEV. (A)	ELEV. (B)	ELEV. (C)	ELEV. (D)	ELEV. (E)	ELEV. (F)	ELEV. (G)	ELEV. (H)	ELEV. (I)
T2-1A	937.63	949.03	944.32	934.34	939.14	948.71	949.71	947.21	944.71
T2-1D	937.63	949.03	944.32	934.30	939.10	948.71	949.71	947.21	944.71

SURVEYOR'S CERTIFICATE

I, Norman Francis Herrmann, a Professional Land Surveyor holding Maryland Registration Land Surveyor #2828, do hereby certify that the building & units are located as shown, that it is based on an accurate transit-tape 'as built' survey, and was prepared for the purpose of establishing 'ANNEN WOODS CONDOMINIUM No. 1'.
This is to certify that I have located the improvements on the lot shown hereon, that such improvements exist, that said improvements lie entirely within the boundaries, and that these plats are a correct representation of the condominium described.

Norman Francis Herrmann
Registered Land Surveyor #2828

E 1K, IR. 4 FOLIO 97
Filed for record
MAY 11 1975
Clerk

ELEVATIONS & FLOOR PLANS

ANNEN WOODS CONDOMINIUM No. 1

3rd Election District Baltimore County, Maryland
Scale: 1/8" = 1'-0" May 28, 1975



MCA
MCA ENGINEERING CORP.
1000 E. JONES ROAD
BALTIMORE, MD. 21204