

#### **REPORT OF SURVEY:**

MD1710 1386 This is page 2 of 2 and is not valid without all pages.

#### LEGAL DESCRIPTION:

OF SAID LOT FOR WALLENGT I FROM INFODORE C. WALLES, ET AL. TO HOWARD D. JOHNSO OF SAID LOT FOR GROUND, SOUTH 47 DEGREES SO MINUTES 25 SECONDS EAST 300 FEET, THEN IG THE SAME COURSE, AND BINDING ON THE SAID NORTHWEST SIDE OF SAID 40 FOOT RIGHT. LEL WITH THE FIRST LINE OF THIS DESCRIPTION, 360 FEET TO INTERSECT THE SAID SOUTHEAST (G, IN ALL, 1378 ACRES. 38 SECONDS WEST 1 FOOT T OTHERS THERETO, SOUTH 44 NDING ON SAID SOUTHEAST TOGETHER WITH THE 40 FOOT RIGHT OF WAY PARTICULARLY DESCRIBED IN THE LEASE DATED JANUARY 19, 1952 AND RECORDED AMONG THE LAND RECORDS OF BALTIMORE CITY IN LIBER M.L.P. NO. 8703, FOLO 477, FROM THEODORE C. WAILES, ET AL, TO PARKS ENGINEERING CO. INC., SAID 40 FOOT RIGHT OF WAY BEING DESIGNARIZED AS LOT 5 IN SAID LEASE AND ON THE PLAT ATTACHED TO AND RECORDED WITH SAID LEASE; TOGETHER ALSO WITH THE RIGHT TO CONSTRUCT AND USE A RAURKOAD SIDE TRACK, ALL AS SET FORTH IN SAID LEASE (SEE ALSO AGREEMENT WITH REFRENCE TO SAID SIDETRACK, DATED DECEMBER 18, 1953 AND RECORDED MICH SAID LEASE (SEE ALSO AGREEMENT WITH REFRENCE TO SAID SIDETRACK, DATED DECEMBER 18, 1953 AND RECORDED THE ALLO WITH WERKTON TO USE A RAURKOAD SIDE TRACK, ALL AS SET FORTH IN SAID LEASE (SEE ALSO WAILES T. AL NO DUVER M. WALKER ET TA, TRUTEES) SAVING AND EXCEPTING FROM THE ABOVE DESCRIBED PARCEL OF LAND, ALL THAT LOT OF GRC AL, CONTAINING 4533.05 SQUARE FEET OF LAND, MORE OR LESS. DESAID LAND RECORDS IN LIRER LEC NO. 1487 FOLIO FOT WAS GR



THE IMPROVEMENTS ON THE ABOVE PARCELS BEING KNOWN AS NO. 4111 MENLO DRIVE

#### JOB SPECIFIC SURVEYOR NOTES:

THE BEARING SYSTEM SHOWN HEREON HAS BEEN REFERENCED TO A DEED AS RECORDED IN LIBER 38544 FOLIO 207 AMONG THE LAND RECORDS OF THE CITY OF BALTIMORE, MARYLAND

ACCURACY EQUALS THREE FEET PLUS OR MINUS

#### GENERAL SURVEYOR NOTES:

- This plat is of benefit to the consumer insofar as it is required by a lender or title insurance company or its agent in
- connection with contemplated transfer, financing or refinancing.
- 2. This drawing is not to be relied upon for the establishment or location of fences, garages, buildings, or other existing or future improvements.
- 3. This drawing does not provide for the accurate identification of the property boundary lines, but this identification might
- not be required for the transfer of title or securing financing or refinancing.
- 4. Unless otherwise noted, no Title Report was furnished to this surveyor. Easements, restrictions, and/ or right-of-ways may exist that are not shown.
- 5. Underground facilities not shown, may exist.
- 6. This survey does not address wetlands, contaminated waste or toxic soil conditions, nor have any reports, studies or information regarding such been provided to this surveyor.
- The information contained on this survey has been performed exclusively, and is the sole responsibility, of Exacta Surveyors. 7. Additional logos or references to third party firms are for informational purposes only.
- Structures are measured at ground level. 8.
- 9. Points of Interest (POI's) are selected above-ground improvements which may be in conflict with boundary, building setback or easement lines. as defined by the parameters of this survey. There may be additional POI's which are not shown, not called-out as POI's, or which are otherwise unknown to the surveyor. These POI's may not represent all items of interest to the viewer.
- 10. Utilities shown on the subject property may or may not indicate the existence of recorded or unrecorded utility easements
- 11. House measurements should not be used for new construction or planning. Measurements should be verified prior to such activity.

O.G. O.R.B O.R.V. O/A O/S OFF OH. OHL ON P.B. P.C.

P.C.C. P.C.P.

P.**I**. P.O.B.

P.O.C. P.P. P.R.C. P.R.M

P.T. P/E PG. PLS PLT PSM

R

LEGEND:

(C) (D) (F) (M) (P) (R) (S) A.S.B.L. A/C B.C. B.F.P.

B.R. B.R.L. B/W BLDG.

BLDG BLK. BM BSMT

C.B. C.L.F. C.O. C.V.G C/L C/P

C/S CATV CH CHIM CONC COR. CS/W D.F. D.H.

LINETYPES: (1	UNLESS OTHERWISE NOTED)
BOUNDARY LINE	
STRUCTURE	OVERHEAD LINES
CENTERLINE	SURVEY THE LINE
CHAIN-LINK or WIRE FENCE	WALL OR PARTY WALL
EASEMENT	WOOD FENCE
EDGE OF WATER	

DEED FIELD MEASURED PLAT RECORD SURVEY ACCESSORY SETBACK LINE AIR CONDITIONING BLOCK CORNER BACKFLOW PREVENTOR BEARING REFERENCE BUILDING REFERENCE BUILDING RESTRICTION LINE BAY/BOX WINDOW BUILDING BLOCK BENCHMARK BASEMENT CURVE CURVE CURVE CURVE CLEAN OUT	E.
	FIPC	FOUND RON PIPE & CAP
	FIR	FOUND RON ROD
	FIRC	FOUND RON ROD & CAP
	FN	
BASEMENT		
CURVE		
CONCRETE BLOCK		
CHAIN LINK FENCE		
CLEAN OUT		
CLEAN OUT		
CONCRETE VALLEY GUTTER CENTER LINE COVERED PORCH CONCRETE SLAB CHORD BEARING CHORD BEARING CHORD BEARING CHIMNEY CONCRETE CORRETE CONCRETE SIDEWALK	ILL. INST. INT. L B# LS# M.B. M.E.S. M.F. MES	ILLEGIBLE INSTRUMENT INTERSECTION LENGTH LCENSE # - BUSINESS LCENSE # - SURVEYOR MAP BOOK MITERED END SECTION METAL FENCE MITERED END SECTION

#### SURVEYOR'S LEGEND

SURFACE 1	YPES: (UNLESS OTHERWISE NOTED)
ASPHALT [	BRICK or TILE
CONCRETE 📑	
water 💋	🥖 wood 🏹
N.T.S.	NOT TO SCALE
NAVD88	NORTH AMERICAN VERTICA
	DATUM OF 1988
NGVD29	NATIONAL GEODETIC
	VERTICAL DATUM OF 1929
0.C.S.	ON CONCRETE SLAB
0.G.	ON GROUND

OIN GROUND OFFICIAL RECORD BOOK OFFICIAL RECORD VOLUME OVERALL OFFSET

OUTSIDE OF SUBJECT PARCEL

OVERHANG OVERHEAD LINES INSIDE OF SUBJECT PARCEL PLAT BOOK

POINT OF COMP COLOR ZURVATURE PERMANENT CONTROL POINT POINT OF INTERSECTION POINT OF BEGINNING POINT OF BEGINNING POINT OF COMMENCEMENT PINCHEO PIPE POINT OF REVERSE CURVATURE PERMANENT REFERENCE MONLIMENT

PAGE PROFESSIONAL LAND SURVEYOR

PROFESSIONAL SURVEYOR AND

POINT OF CURVATURE

POINT OF TANGENCY POOL EQUIPMENT

MAPPER RADIUS or RADIAL

PLANTER

v	ELEVATION
	DADIUG DOINT
к.р. R/W	RADIUS POINT
	RESIDENCE
	RANGE
	SET BACK LINE
	SURVEY CLOSURE LINE
	SURVEY TIE LINE
	SEAWALL
	SET GLUE DISC
	SIDEWALK
	SCREEN
	SECTION
	SEPTIC TANK
	SEWER
	SET IRON ROD & CAP
	SET NAIL & DISC
	SQUARE FEET
	STORY
	SEWER VALVE
	TOP OF BANK
	TEMPORARY BENCHMAR
	TELEPHONE FACILITIES
	TOWNSHIP
	TRANSFORMER
	TYPICAL
	UTILITY RISER
	UNDERGROUND
UR	UTILITY RISER
	VINYL FENCE
W.F.	WOODEN FENCE
W/C	WITNESS CORNER

WATER FILTER

WATER METER/VALVE BOX

SYMBOLS

6

(3) ⇒ (3) ●

BENCH MARK

CENTERLINE

CONCRETE CATCH BAS

⊕ ⊊ ∆

Ż

W/F


WM

FIRE HYDRANT	
FND OR SET MONUMEN	π
GUYWIRE OR ANCHOR	
MANHOLE	
TREE	
UTILITY OR LIGHT POLE	
WELL	

A.E.	ACCESS EASEMIENT
AN.E.	ANCHOR EASEMENT
C.M.E.	CANAL MAINTENANCE ESMT.
C.U.E.	COUNTY UTILITY ESMT.
D.E.	DRAINAGE EASEMENT
D.U.E.	DRAINAGE AND UTILITY ESMT.
ESMT.	EASEMENT
I.E./E.E.	INGRESS/EGRESS ESMT.
RR.E.	IRRIGATION EASEMENT
L.A.E.	LIMITED ACCESS ESMT.
L.B.E.	LANDSCAPE BUFFER ESMT.
L.E.	LANDSCAPE ESMT.
L.M.E.	LAKE OR LANDSCAPE
	MAINTENANCE EASEMENT
M.E.	MAINTENANCE EASEMENT
P.U.E.	PUBLIC UTILITY EASEMENT
R.O.E.	ROOF OVERHANG ESMT.
S.W.E.	SIDEWALK EASEMENT
S.W.M.E.	STORM WATER MANAGEMENT
	EASEMENT
T.U.E.	TECHNOLOGICAL UTILITY ESMT
U.E.	UTILITY EASEMENT

ACCESS EASEMENT

### ELECTRONIC SIGNATURE

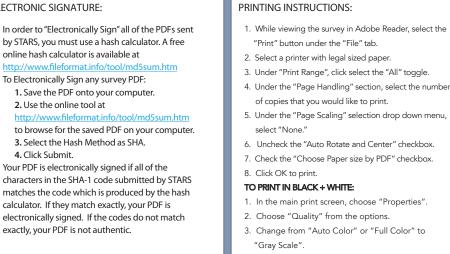



#### EXACTA MARYLAND SURVEYORS, INC

LB# 21535

o: 443.819.3994 1220 E Churchville Road | Bel Air. MD 21014



Exacta Maryland Surveyors, Inc.

1220 E Churchville Road | Suite 100 Bel Air, MD 21014 Contact Us Phone (443)692-6523 Fax (443)692-6524 Toll Free: 866-735-1916

www.exactaMD.com

LB# 21535

# STATE OF MARYLAND REQUIRED APPROVAL FORM

## PRIOR TO CLOSING, PLEASE SIGN & EMAIL this page to ORDERS@EXACTAMD.COM for COMAR compliance.

Exacta Maryland Surveyors, Inc. has been requested to prepare a location drawing. A location drawing shows the property inspected and the locations of buildings or other visible improvements affecting the property. A LOCATION DRAWING IS NOT A BOUNDARY SURVEY AND CANNOT BE **RELIED UPON BY ANYONE TO SHOWWHERE THE PROPERTY'S BOUNDARIES ARE.** The only purpose of a location drawing is to provide some assurancethat improvements are located on the property. This assurance is for the use of a lender or an insurer only. If a boundary survey, which could be relied upon for various purposes (for example setting the property markers, erecting a fence, building a garage, or making other improvements on the property), is desired, a surveyorshould be contacted independently. The cost of a boundary survey will be greater than the cost of a locationdrawing.

For further information, contact: Exacta Maryland Surveyors, Inc. at 1220 E Churchville Road, Suite 100 BEL AIR, MD 20613, (443) 692-6523 or www.exactamd.com. I/we approve the preparation of a location drawing.

I/we have read and understand that, in the absence ofany problem revealed by or during the

preparation of this drawing, it will be all that is required by the lendinginstitutions and title companies for settlement.

I/we request a boundary survey that will include a location drawing, and will identify property boundarylines and mark property boundary corners. I/we have read and understand that this may not be required for settlement purposes.

Consumer's Signature:	Date:
<u> </u>	
Phone Number:	

In connection with the purchase or refinancing of the property located at:




LES, TO THE PLACE OF BEGINNING. CONTINUING IN ALL, 1378 ACRES.
TOGETHER WITH THE 40 FOOT RIGHT OF WAY PARTCULARLY DESCRIBED IN THE LEASE DATED JANUARY 19, 1952 AND RECORDED AMONG THE LAND RECORDS OF BALTMORE CITY IN UBER M.L.P. NO. 8703, FOUL 477, FROM THEODORE C. WALES, ET AL, TO PARKS ENGINEERING CO. INC., SAD 40 FOOT RIGHT OF WAY BEING DESIGNATED AS LOT F LEASE AND ON THE PLAT ATTACHED TO AND RECORDED WITH SUD LEASE. TOGETHER ALSO WITH THE RIGHT TO CONSTRUCT AND USE A RALIKOAD SIDE TRACK, ALL AS SET FORTH IN SAD LEASE [SEE ALSO AGREEMENT WITH REFERENCE TO SAD SDETRACK, DATED DECEMBER 18, 1953 AND RECORDED AMONG THE AFORESAD LAND RECORDED AMONG THE 
SANKE AND EXCEPTING FROM THE ABOVE DESCRIBED PARCEL OF LAND, ALL THAT LOT OF GROUND WHICH BY DEED DATED MAY 7, 1943 AND EXCEPTION FROM THE APORESAID LAND BECORDS IN LIBER J.F.C. NO. 1487 FOLIO 507, WAS GRANTED AND CONVEYED BY FARM-RITE IMPLEMENT COMPANY TO THEODORE C. WALLES, ET AL, CONTAINI SUBJECT FEET OF LINKIN, OWNE OF LISS.
THE UNFOUNDMENTS ON THE ABOVE PARCELS BEING KNOWN AS NO. 4111 MENIO DEVE.
CLIENT NAME
COMMERCE TITLE COMPANY, INC PIKESVILLE