
REVISIONS

Dimensions of Lot 1 From Housing Authority Survey C.Sh. 2131 & 2132
Lot 47 Changed to Lot 47/66 Per P.S. C.Sh. 2112A
Lot 41 Ho. No. Per P.L.S. C. Sh. 8A
LOTS 33 & 34 CONS'D PER O.O. C.SH 98-134

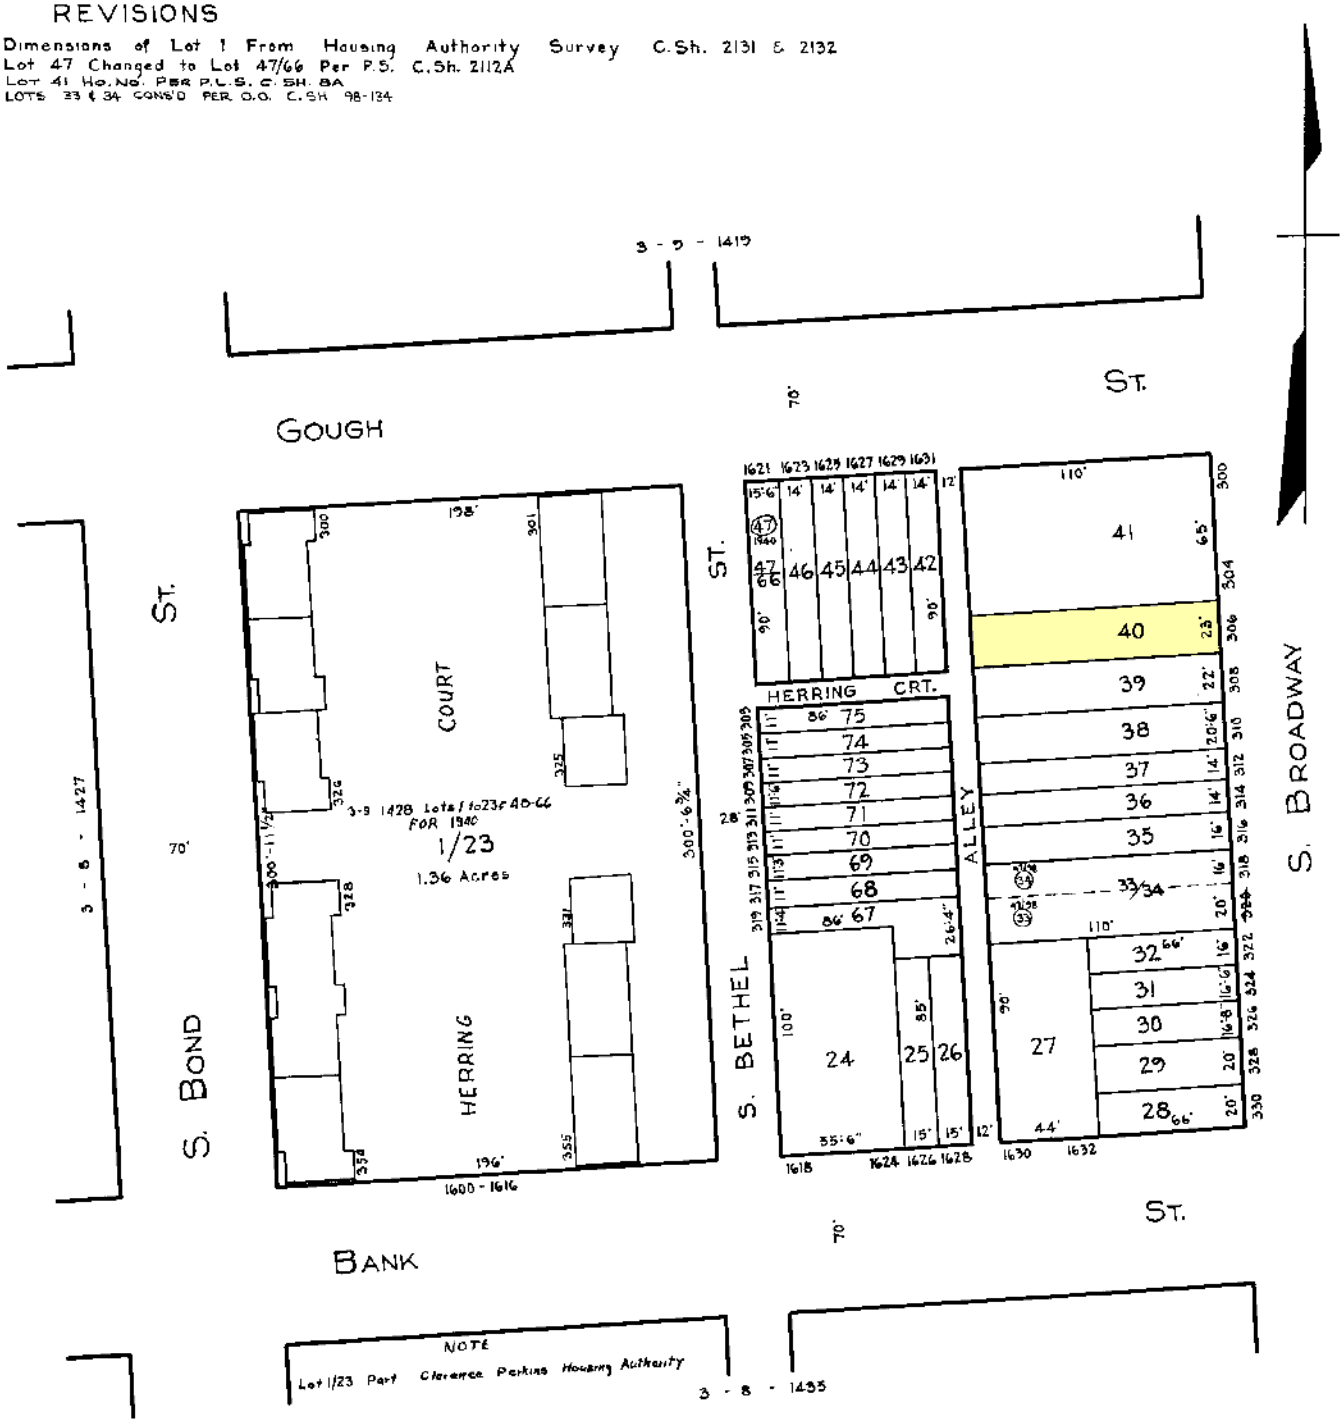

NOTICE

THIS IS A ~~REAL PROPERTY~~ PLAT AS ~~REQUIRED~~ FOR UNDER ARTICLE 7011 OF THE CITY CHARTER. IT IS COMPILED FROM TITLE AND OTHER SOURCES AND IS NOT AN AUTHENTIC SURVEY.

TRACED BY P. Maggio
LETTERED BY P. Maggio
CHECKED BY

CITY OF BALTIMORE
DEPARTMENT OF PUBLIC WORKS
BUREAU OF PLANS & SURVEYS
PROPERTY LOCATION DIVISION

WARD 3 SECTION 9
BLOCK 1428

SCALE 1" = 50' DATE SEPT. 1940